



GARDEN EDGE — CORRECTED SHAPE (site photo + your blue mark-up)

1 SECTION ACROSS AT C1 — 1:25 (corrected)


tall house wall LEFT — garden RIGHT, as your mark-up

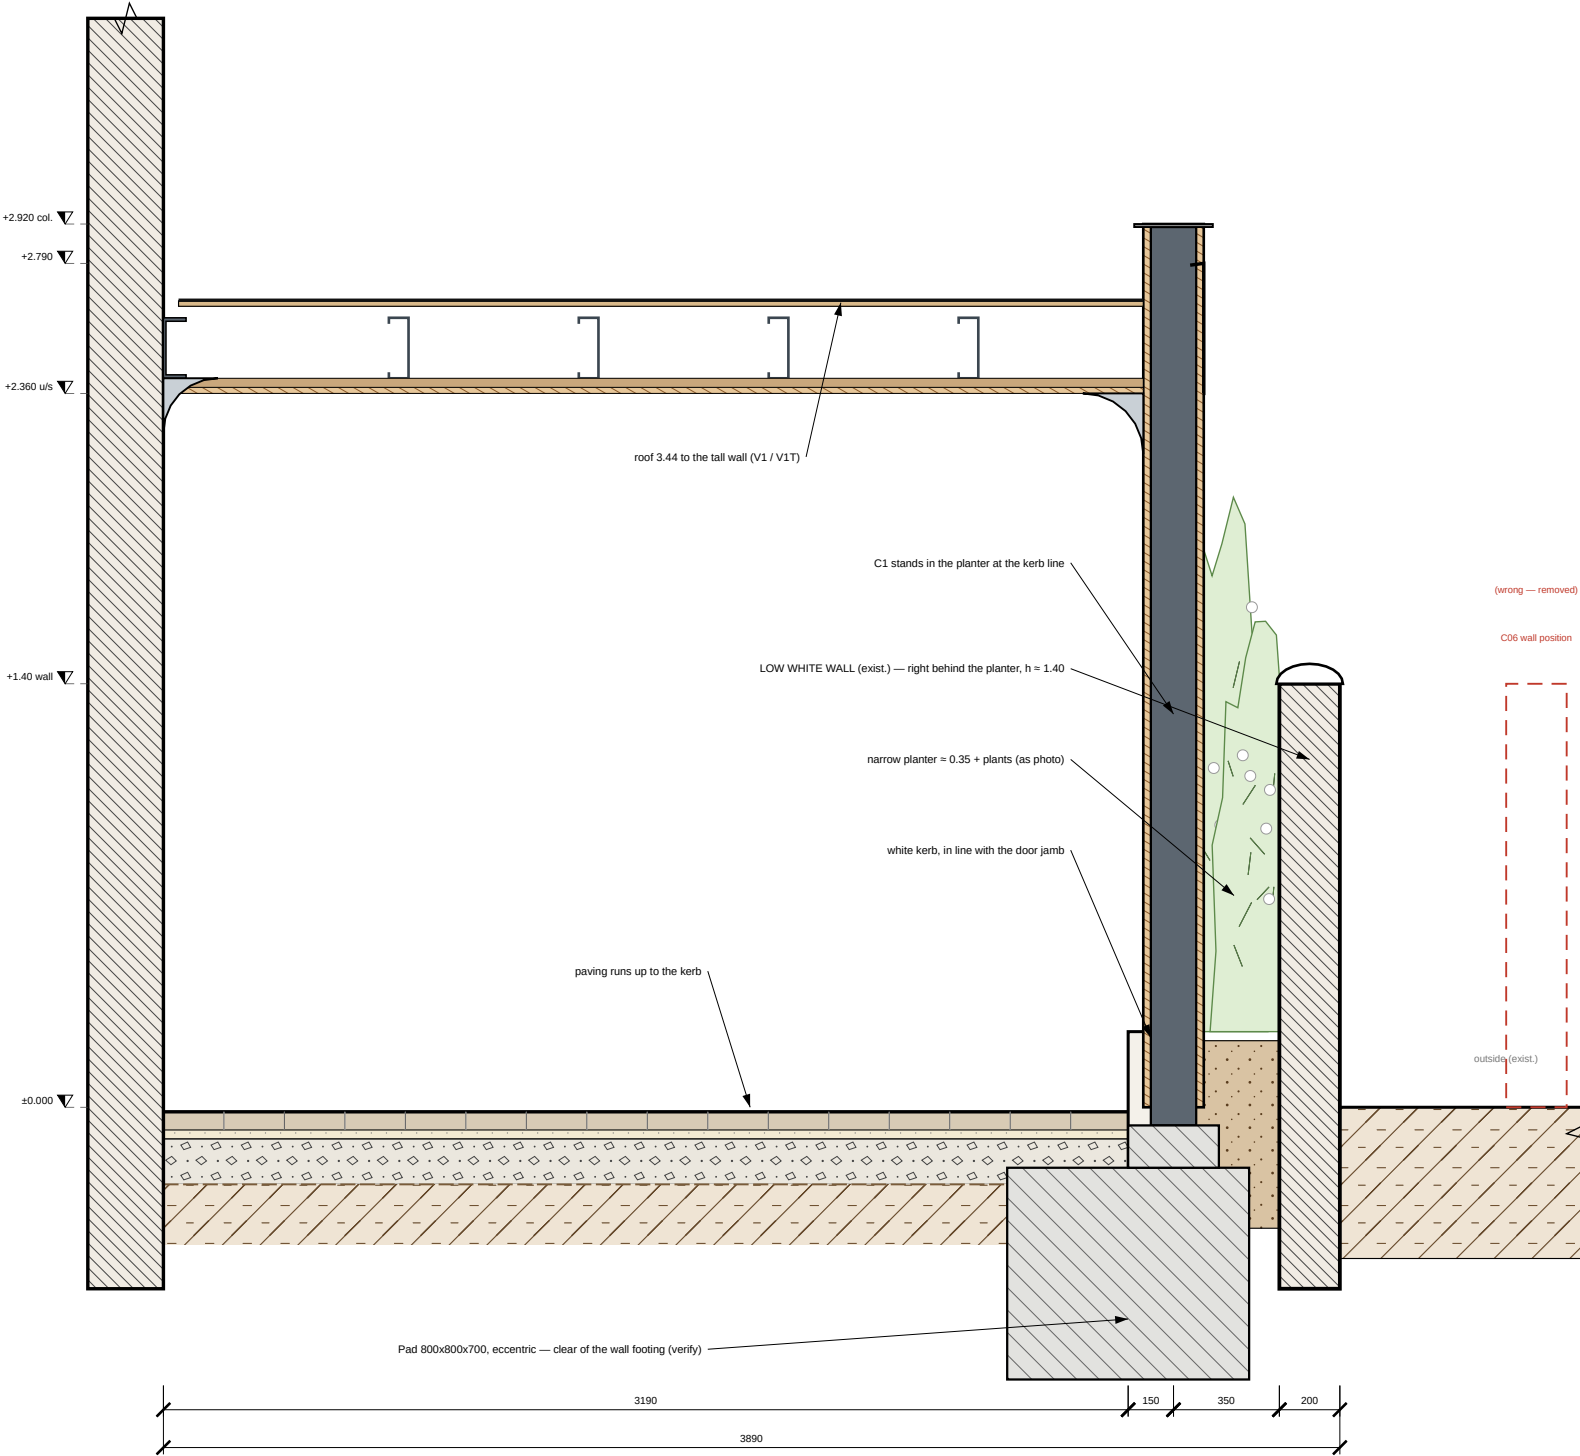

2 KEY PLAN — 1:100 (triangle shown; same edge for all)

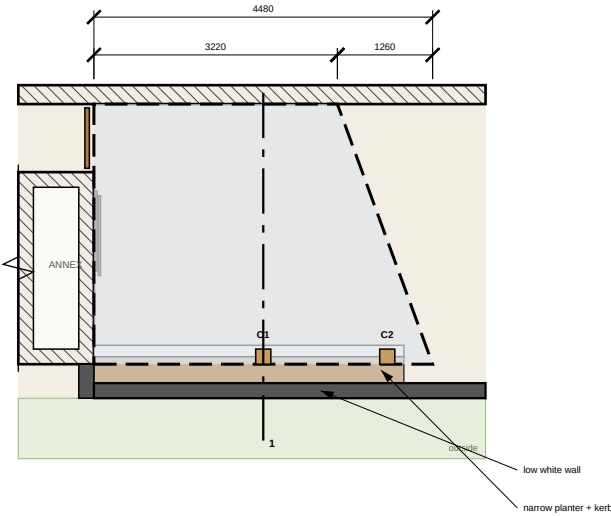

3 3D — SAME DIRECTION AS THE SITE PHOTO

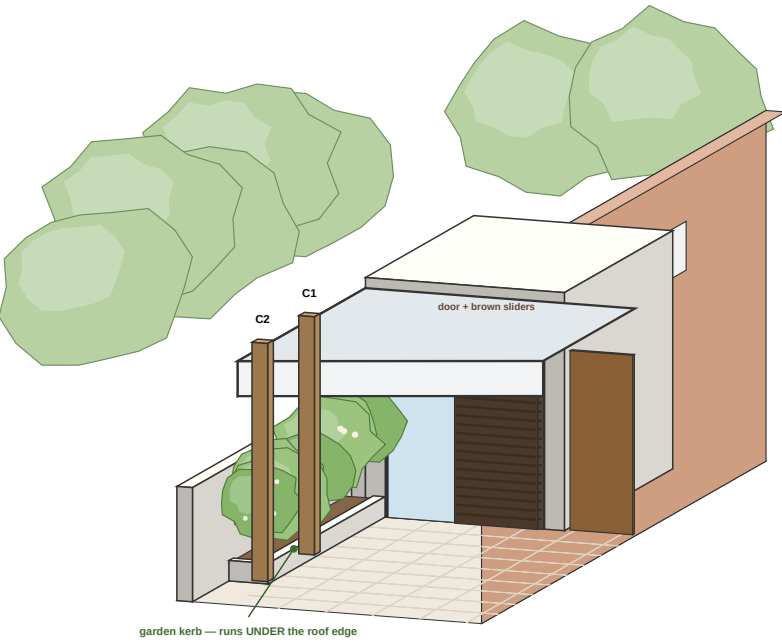

WHAT CHANGED
As the photo: kerb → narrow planter → low white wall right behind it (your blue line). In C06 the wall was ~1 m too far out — removed.
C1 / C2 stand in the planter at the kerb line, under the roof edge.
Same edge for V1, V2, V1T, V2T — confirm and all 12 sheets follow.
PLEASE CONFIRM / MEASURE
Planter width kerb-to-wall (drawn = 0.50 incl. kerb), wall height (= 1.40) and thickness (0.20).

COURTYARD ROOF — GARDEN EDGE

As site photo + client mark-up: kerb -> narrow planter -> low white wall right behind it; C1 / C2 in the planter under the roof edge.
Client: Owner / Client
Design & drawings: Claude Code

- DRAWING NOTES**
- Do not scale from this drawing. Use figured dimensions only.
 - All dimensions in millimetres; levels in metres relative to internal FFL ±0.000 (datum to be tied to site survey).
 - Contractor to verify all dimensions, levels & existing structure on site before fabrication or ordering.
 - Read with all other architectural, structural & services drawings and the specification notes (A-001).
 - Structural members are preliminary: final design, connections & calculations by a licensed structural engineer to local code before construction.
 - Report any discrepancy to the designer before proceeding.

REVISIONS		
Rev	Date	Description
C07	07.10.2026	Low white wall moved in, directly behind the narrow planter
C06	07.10.2026	Garden = planter in front of the façade, left of the door, partly under roof
C05	07.10.2026	Triangular versions V1T/V2T; 3D views; details D3
C04	07.10.2026	Two versions V1/V2 per client sections & site photo

FOR CLIENT CONFIRMATION — shape only; full set follows once confirmed

DRAWING TITLE
**GARDEN EDGE — corrected shape
section, key plan & 3D**

SCALE @ A3 1:25 / 1:100	DATE 07.10.2026
DRAWN / CHECKED CC / —	SERIES ARCHITECTURAL

DRAWING No. REV

C07-01 **C07**